


HANNIBAL SQ, LTD - LANDLORD
558 W. NEW ENGLAND AVE - SUITE "250"
WINTER PARK, FL 32789
SECOND FLOOR
3300 SQ.FT. USEABLE
4154 SQ.FT. RENTABLE

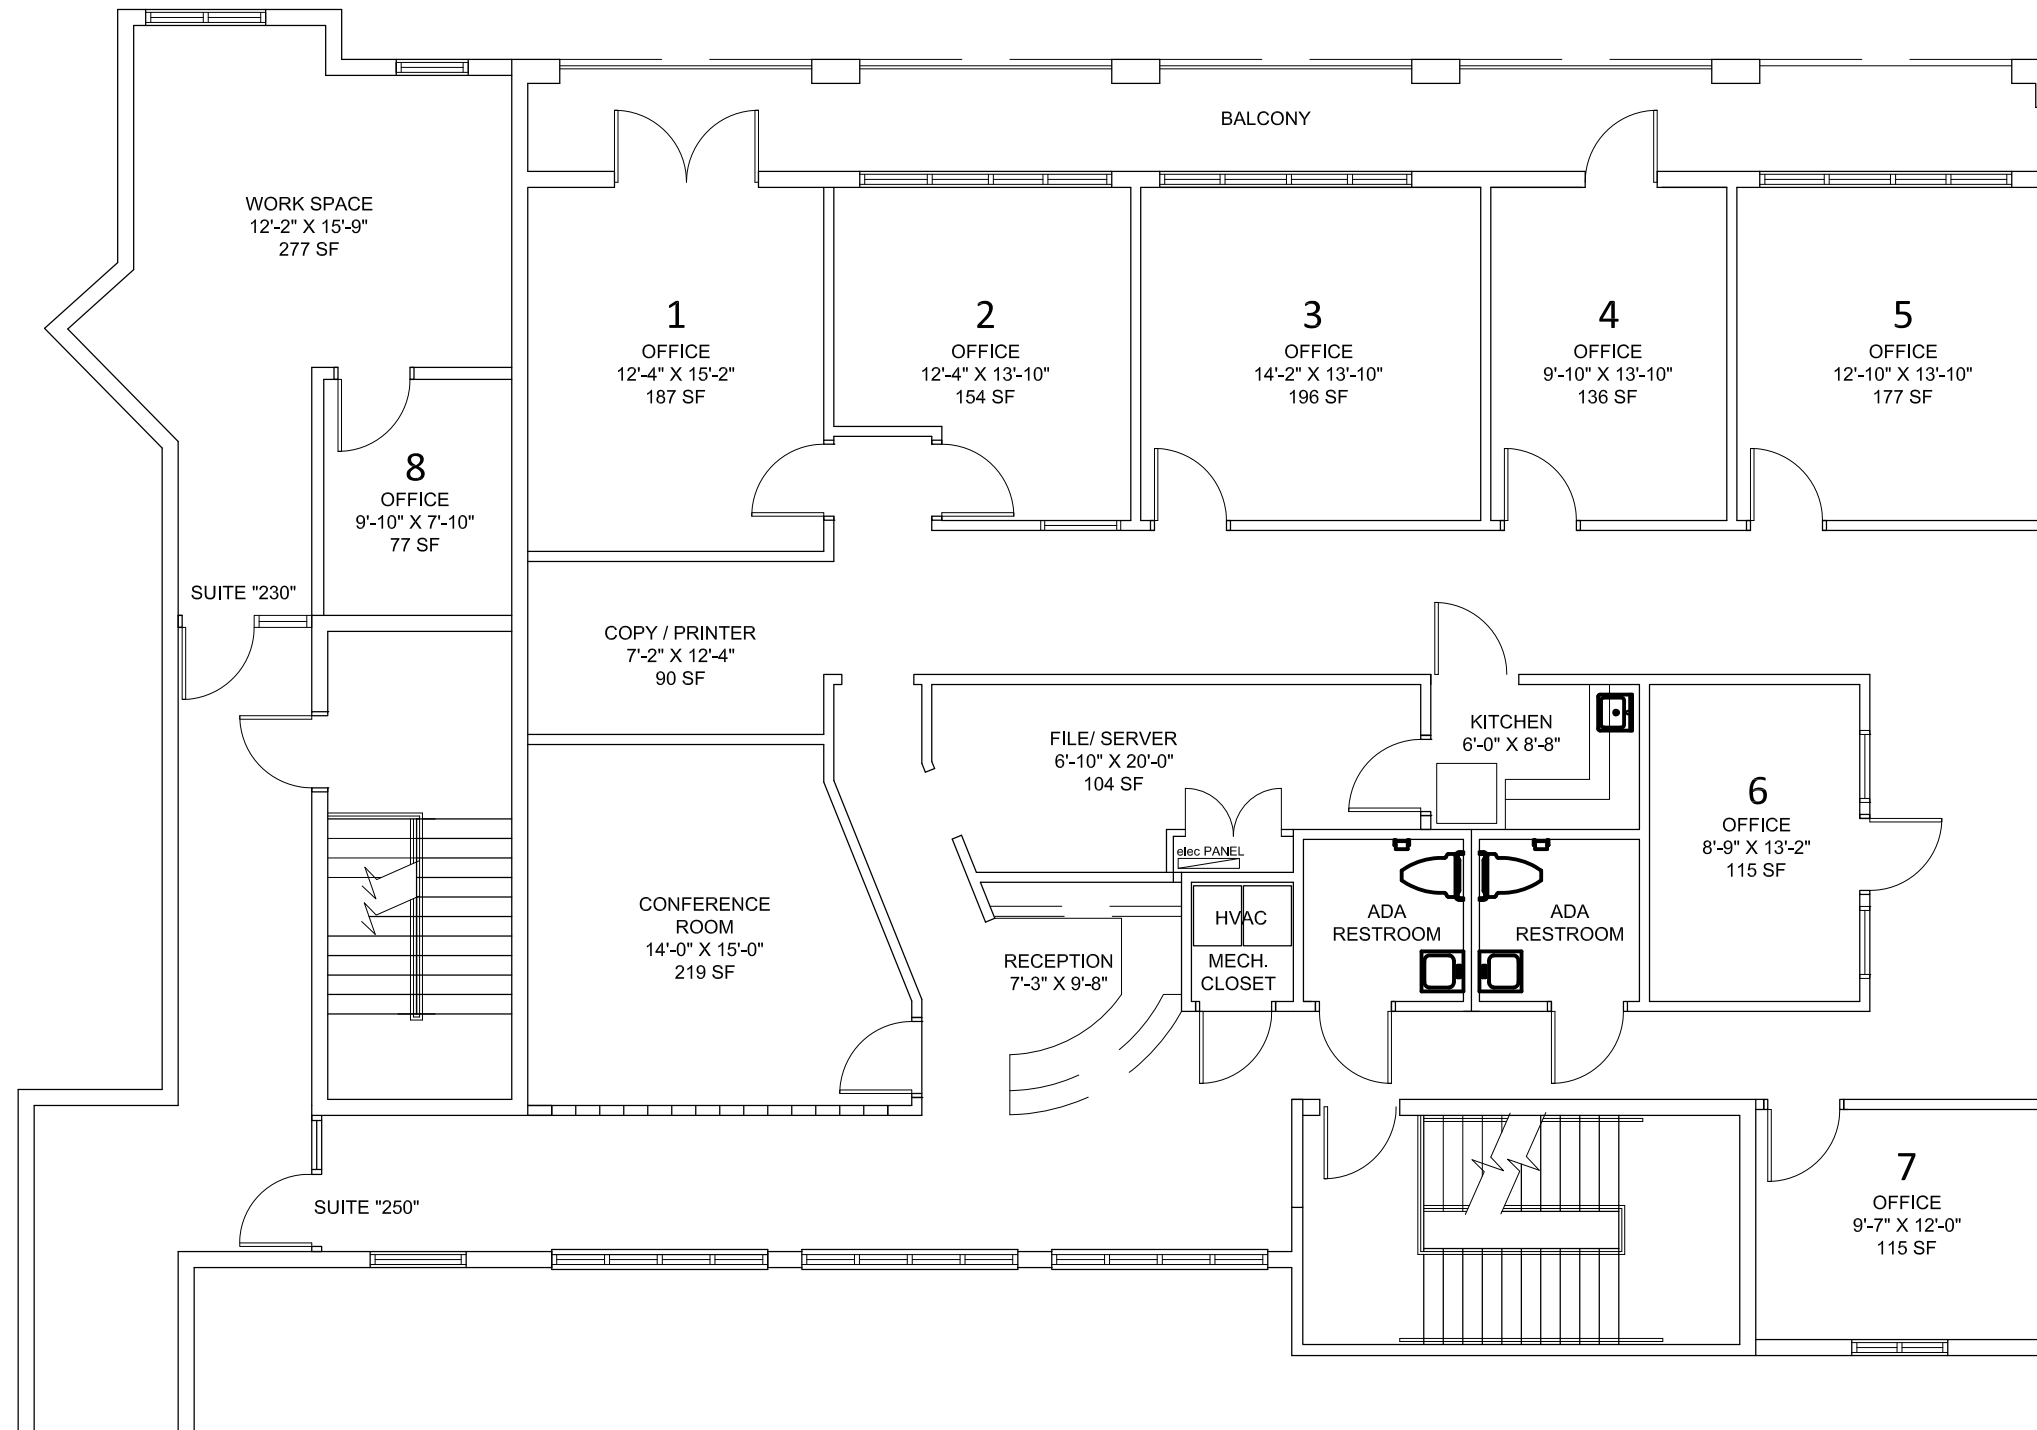

AS-BUILT
SCALE: 1/8" = 1'-0"
(WHEN PRINTED ON 11X17)